


HIDDEN CANYON

UNIT - 211

AREA TABULATION

SUITE 211 LEASABLE SPACE =

1002 S.F.

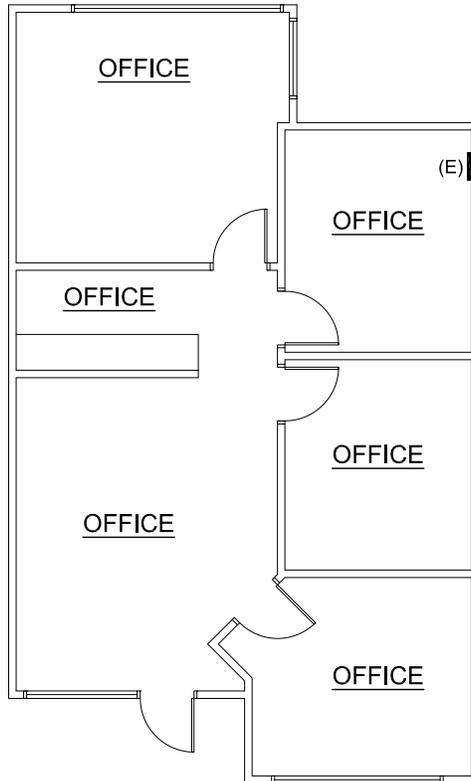

1 #211 AS-BUILT PLAN
A1.00

NOTES:

- (D) DATA
- (E) ELECTRIC PANEL
- (C) CABLE

FIRE SPRINKLED - YES
 FIRE ALARMED - YES

#	DATE	DESCRIPTION			
1			DRAFTING COMPANY: STREAMLINE CONCEPT DRAFTING & DESIGN, LLC	PROJECT NAME: HIDDEN CANYON PLAZA SHOPPING CENTER	PLOT DATE: 02-29-2020
			COMPANY ADDRESS: 6935 ALIANTE PARKWAY, STE. 104-432 NORTH LAS VEGAS, NEVADA 89084	PROJECT ADDRESS: 3915-3965 MARTIN LUTHER KING BOULEVARD NORTH LAS VEGAS, NEVADA 89032	PHASE AS-BUILT SUBMITTAL
			COMPANY CONTACT: DYLAN YORKE - OWNER 702-416-0795	PROJECT NUMBER: 016-18001	SHEET NAME AS-BUILT FLOOR PLAN
					SHEET NO. A1.00